BRIGHAM RESIDENCE

Bakersfield, VT

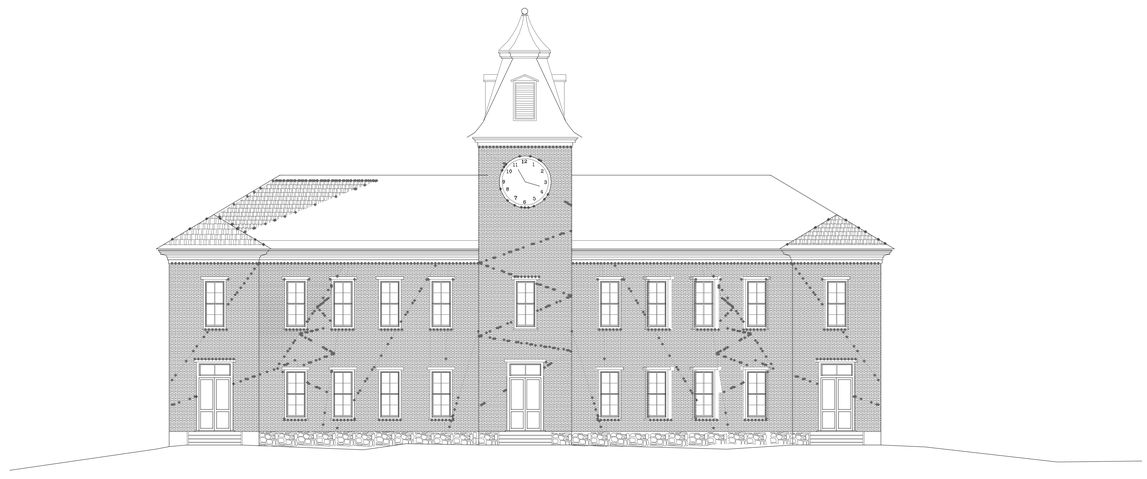

Existing Document Set
4/6/20

Dreher Design
Tel: 802.355.7415

4/6/2020 2:49:39 PM , 1:50 A0B

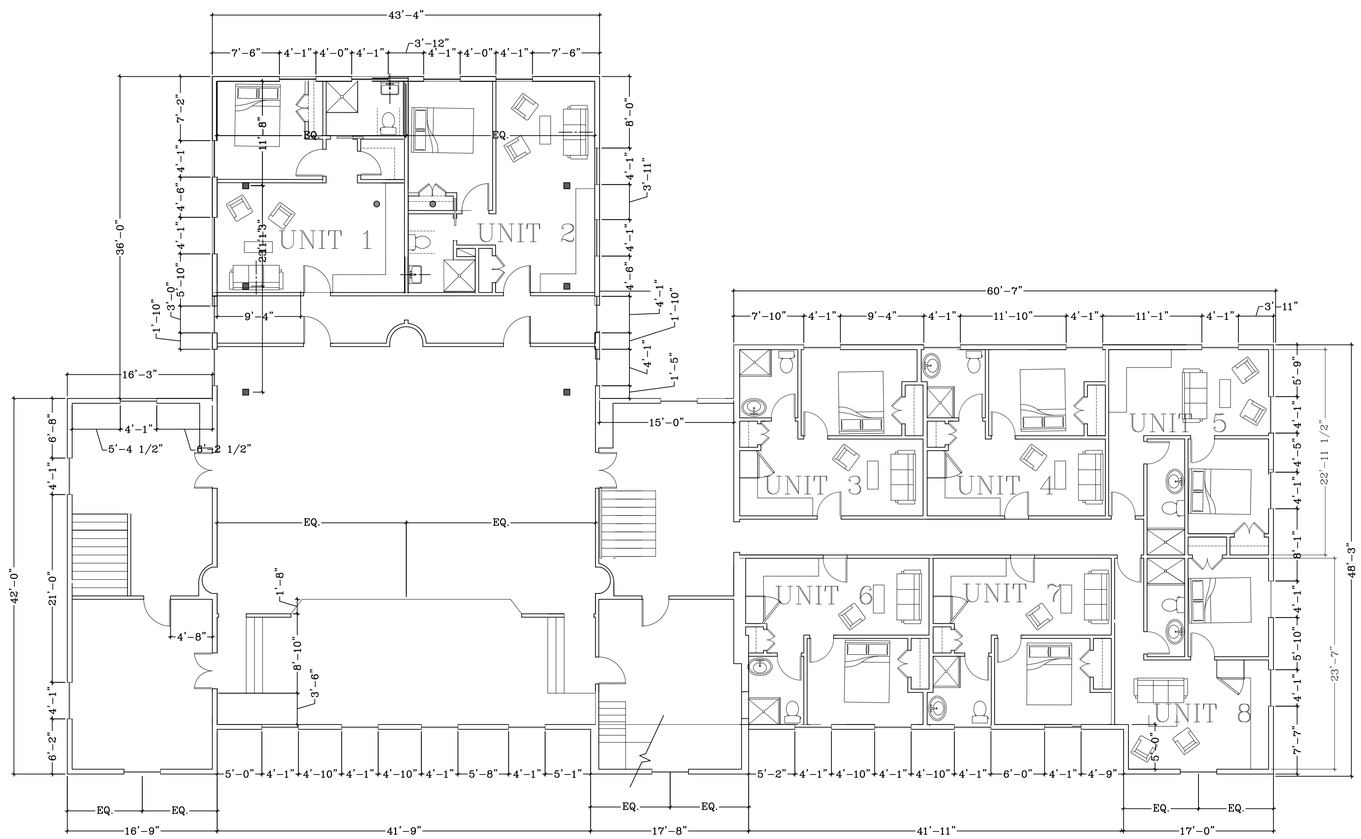

BRIGHAM ACADEMY, Proposed Plan (3 floors)

☐ In-House	☐ Issue	
1	03.24.20	Existing
2	06.27.23	Proposed
3		
4		
5		
6		

Consultant Name
Street
Town name, State Zip
Phone #
Fax: #

Brigham Academy

72 Academy Lane
Bakersfield, Vermont

06/27/2023
2023 Brig

Proposed Plan

A1.01

~~proposed~~ PJD

© Paul Dreher Architect

Date:

1 Proposed Plan 1-3 (22) 1 Bdr. Units

Scale: 1" = 8'-0"

These documents illustrate an original design by Dreher Design (the "Architect"). They are the property of the Architect, who retains all common law, statutory and other reserved rights, including the copyright. They may not be reproduced or used for any purpose without the Architect's written consent.

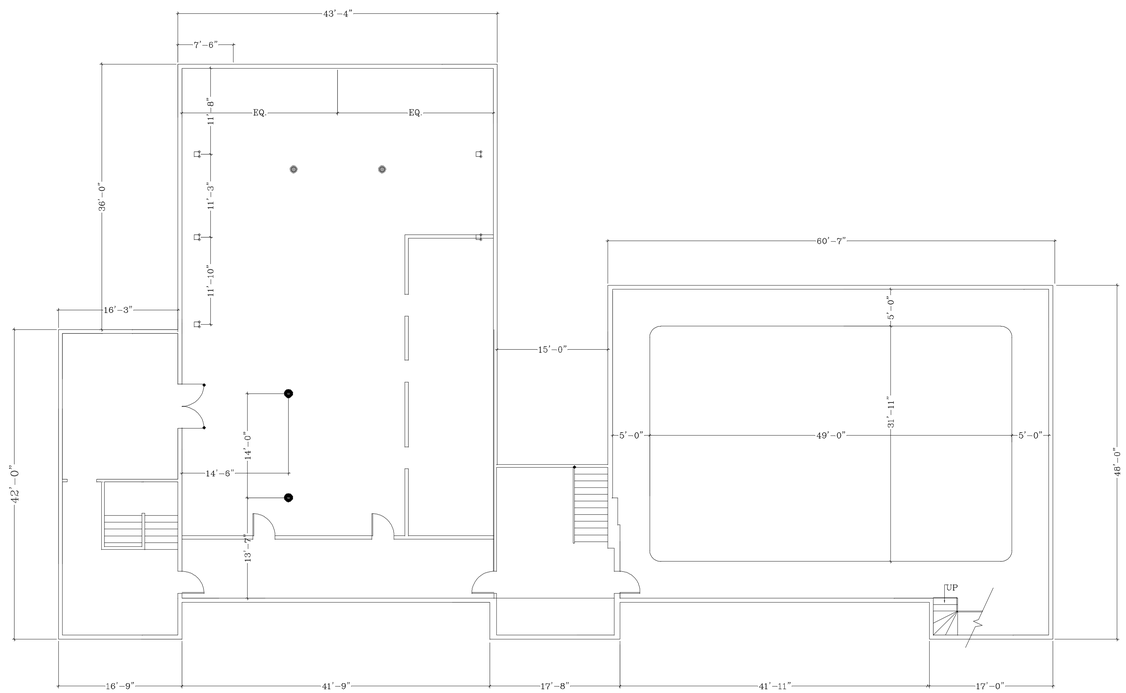

BRIGHAM ACADEMY, BASEMENT. EXISTING PLAN

1	Existing Plan Basement	Scale: 1" = 8'-0"

These documents illustrate an original design by Dreher Design-Paul Dreher. They are the property of the Dreher Design, who retains all common law, statutory and other reserved rights, including the copyright. They may not be reproduced or used for any purpose without the Dreher Design's written consent.

☐ In-House ☐ Issue

1	03.24.20	Existing
2		
3		
4		
5		
6		

TCE
XXXX
XXXXX
XXXXX

Brigham Academy

72 Academy Lane
Bakersfield, Vermont

03/24/2020
2021 Brig

Existing Conditions

A1.03

As-Built PJD

© Dreher Design-Paul Dreher

Date:

4/03/2021 12:26:47 PM, 1:1

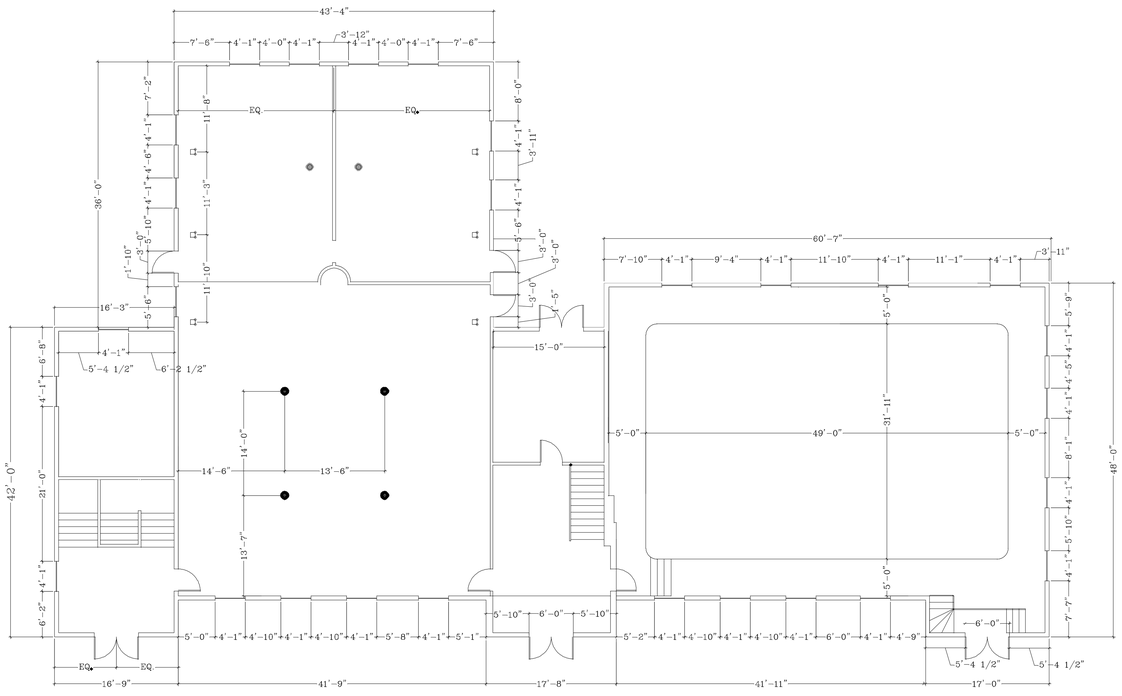

BRIGHAM ACADEMY, FLOOR 1. EXISTING PLAN

1	Existing Plan	Scale: 1" = 8'-0"

These documents illustrate an original design by Dreher Design-Paul Dreher. They are the property of the Dreher Design, who retains all common law, statutory and other reserved rights, including the copyright. They may not be reproduced or used for any purpose without the Dreher Design's written consent.

☐ In-House ☐ Issue

1	03.24.20	Existing
2		
3		
4		
5		
6		

TCE
XXXX
XXXXX
XXXXX

Brigham Academy

72 Academy Lane
Bakersfield, Vermont

03/24/2020
2021 Brig

Existing Conditions

A1.00

As-Built PJD

© Dreher Design-Paul Dreher

Date:

4/2020 12:04:31 PM, 1:1

BRIGHAM ACADEMY, FLOOR 1. EXISTING PLAN

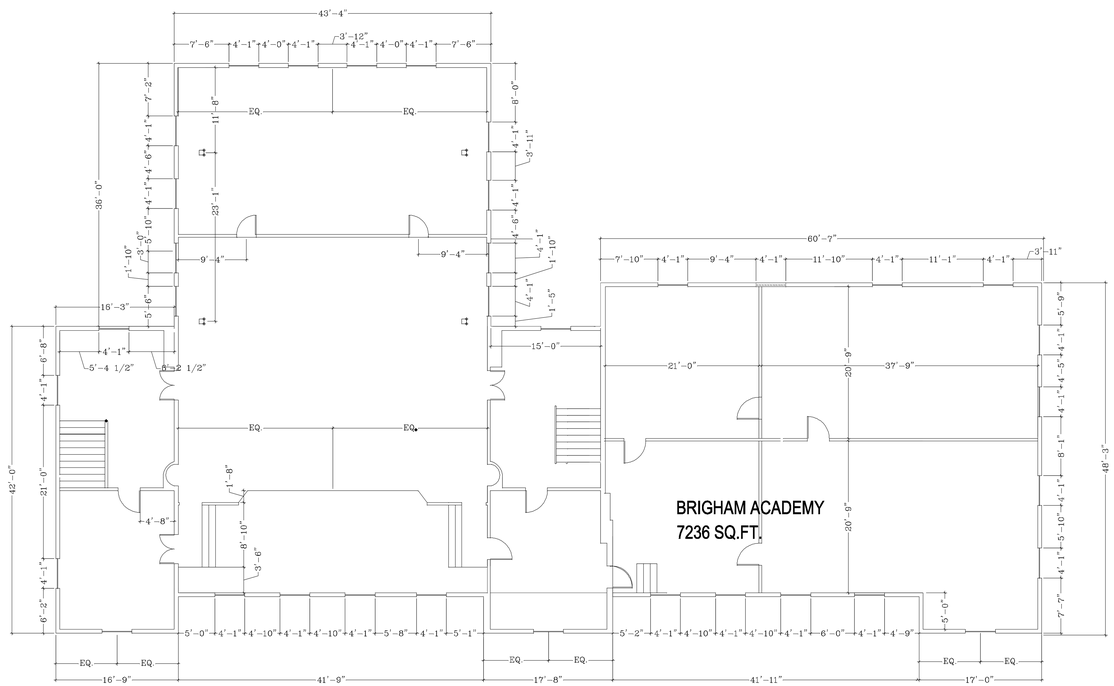

BRIGHAM ACADEMY, FLOOR 2. EXISTING PLAN

1 Existing Plan 2nd Floor

Scale: 1" = 8'-0"

These documents illustrate an original design by Dreher Design-Paul Dreher. They are the property of the Dreher Design, who retains all common law, statutory and other reserved rights, including the copyright. They may not be reproduced or used for any purpose without the Dreher Design's written consent.

☐ In-House ☐ Issue

1	03.24.20	Existing
2		
3		
4		
5		
6		

TCE
XXX
XXXXX
XXXXX

Brigham Academy

72 Academy Lane
Bakersfield, Vermont

03/24/2020
2021 Brig

Existing Conditions

A1.01

As-Built PJD

© Dreher Design-Paul Dreher

Date:

3/26/2020 12:07:44 PM 1:1

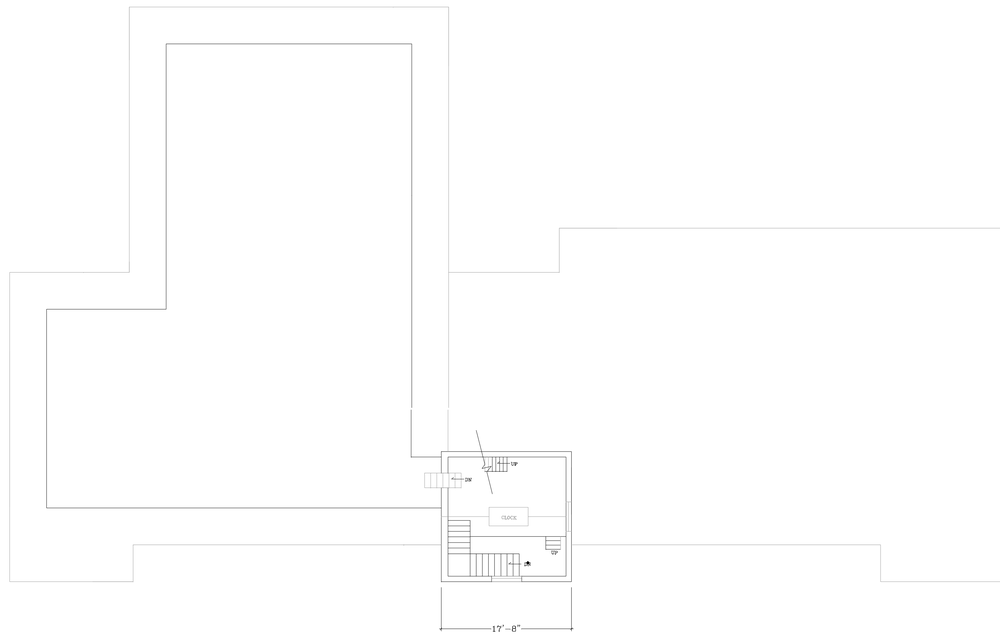

BRIGHAM ACADEMY, ATTIC EXISTING PLAN

1	Existing Plan ATTIC	Scale: 1" = 8'-0"

These documents illustrate an original design by Dreher Design-Paul Dreher. They are the property of the Dreher Design, who retains all common law, statutory and other reserved rights, including the copyright. They may not be reproduced or used for any purpose without the Dreher Design's written consent.

☐ In-House ☐ Issue

1	03.24.20	Existing
2		
3		
4		
5		
6		

TCE
XXXX
XXXXX
XXXXX

Brigham Academy

72 Academy Lane
Bakersfield, Vermont

03/24/2020
2021 Brig

Existing Conditions

A1.04

As-Built PJD

© Dreher Design-Paul Dreher

Date:

4/8/2020 10:19:28 AM 1:1

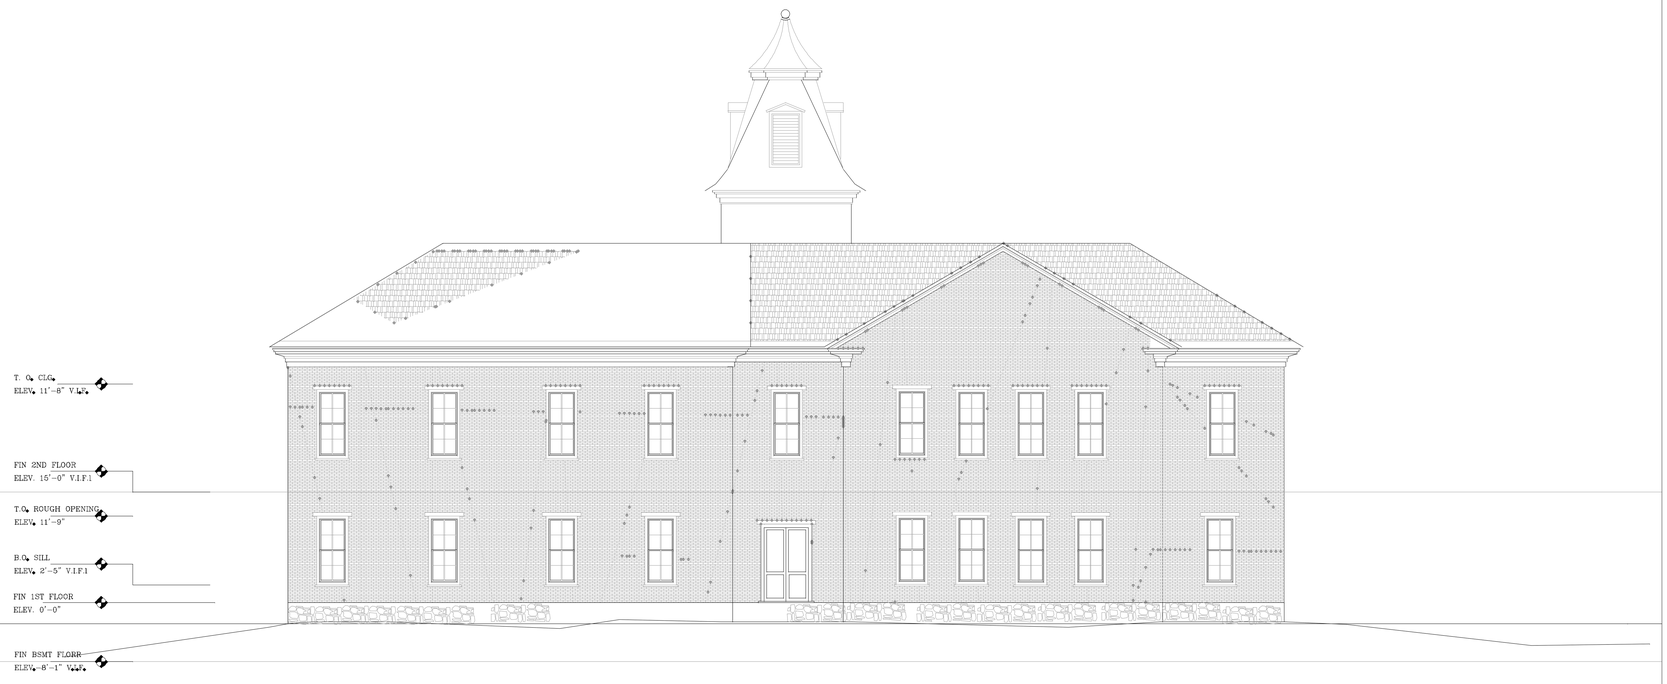

1 Existing West Elevation

Scale: 1" = 8'-0"

These documents illustrate an original design by Dreher Design-Paul Dreher. They are the property of the Dreher Design, who retains all common law, statutory and other reserved rights, including the copyright. They may not be reproduced or used for any purpose without the Dreher Design's written consent.

☐ In-House		☐ Issue
1	03.24.20	Existing
2	04.02.20	Exist. Elev.
3		
4		
5		
6		

TCE
XXXX
XXXXX
XXXXX

Brigham Academy

72 Academy Lane
Bakersfield, Vermont

04/02/2020
2021 Brig

Existing Conditions

A2.01

As-Built Elevation PJD

© Dreher Design-Paul Dreher

☐ Date:

4/02/20 12:00:42 PM, 1:1

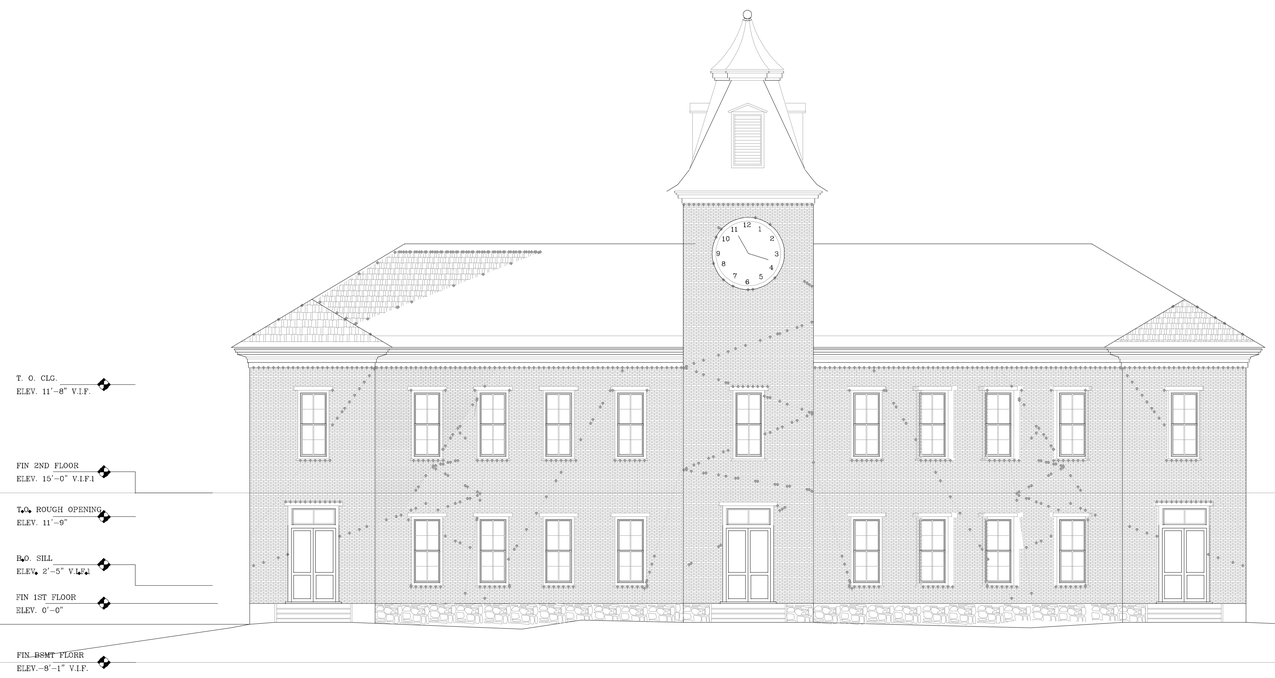

1 Existing East Elevation

Scale: 1" = 8'-0"

These documents illustrate an original design by Dreher Design-Paul Dreher. They are the property of the Dreher Design, who retains all common law, statutory and other reserved rights, including the copyright. They may not be reproduced or used for any purpose without the Dreher Design's written consent.

☐ In-House		☐ Issue
1	03.24.20	Existing
2	04.02.20	Exist. Elev.
3		
4		
5		
6		

TCE
XXXX
XXXXX
XXXXX

Brigham Academy

72 Academy Lane
Bakersfield, Vermont

04/02/2020
2021 Brig

Existing Conditions

A2.00

As-Built Elevation PJD

© Dreher Design-Paul Dreher

☐ Date:

4/02/20 12:00:13 PM, 1:1

1 Existing North Elevation Scale: 1" = 8'-0"

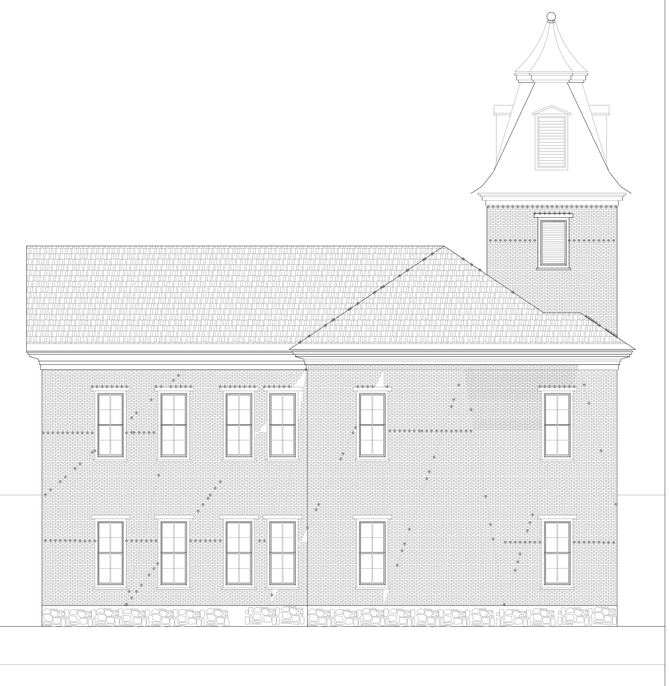

2 Existing South Elevation Scale: 1" = 8'-0"

These documents illustrate an original design by Dreher Design-Paul Dreher. They are the property of the Dreher Design, who retains all common law, statutory and other reserved rights, including the copyright. They may not be reproduced or used for any purpose without the Dreher Design's written consent.

☐ In-House ☐ Issue

1	03.24.20	Existing
2	04.02.20	Exist. Elev.
3		
4		
5		
6		

TCE
XXXX
XXXXX
XXXXX

Brigham Academy

72 Academy Lane
Bakersfield, Vermont

04/02/2020
2021 Brig

Existing Conditions

A2.02

As-Built Elevation PJD

© Dreher Design-Paul Dreher

Date:

4/13/2021 12:05:28 PM, 1:1

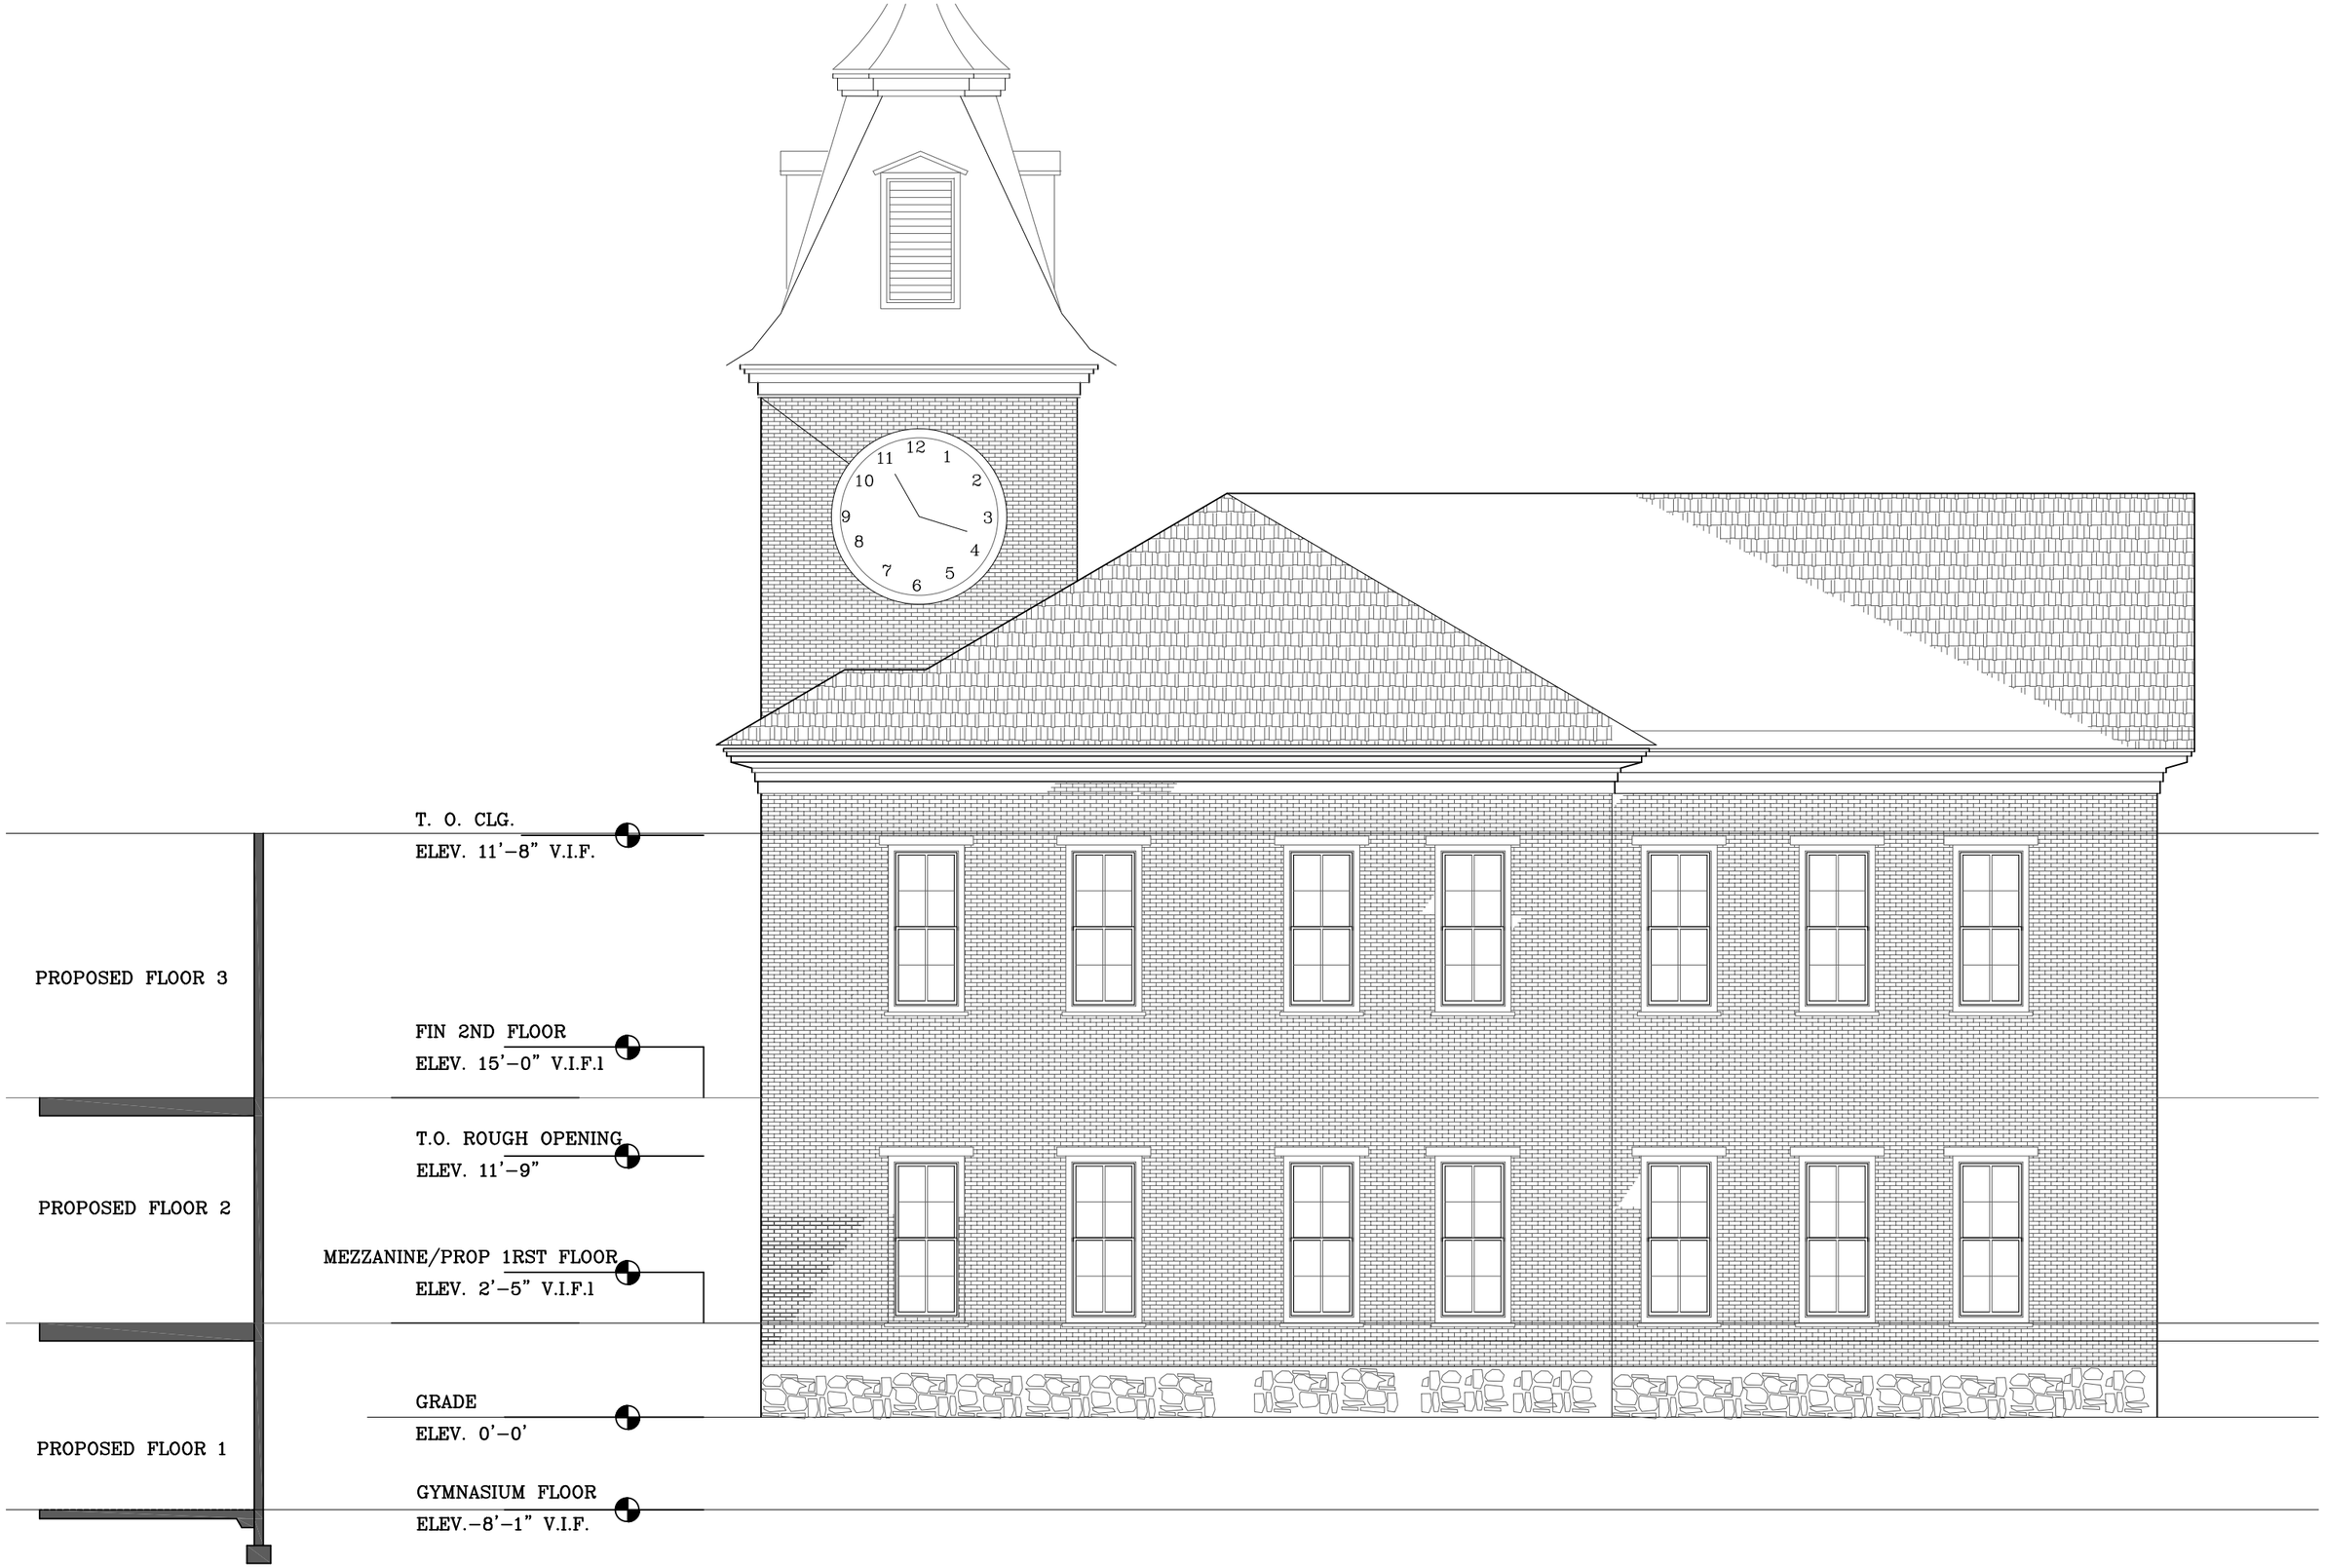
12
1
2
3
4
5
6
7
8
9
10
11
T. O. CLG.
ELEV. 11'-8" V.I.F.
PROPOSED FLOOR 3
FIN 2ND FLOOR
ELEV. 15'-0" V.I.F.1
T.O. ROUGH OPENING
ELEV. 11'-9"
PROPOSED FLOOR 2
MEZZANINE/PROP 1RST FLOOR
ELEV. 2'-5" V.I.F.1
GRADE
ELEV. 0'-0'
PROPOSED FLOOR 1
GYMNASIUM FLOOR
ELEV.-8'-1" V.I.F.